

Date: Thursday, 3/16/2006 10:38:38 AM  
 User: Kim Johnston

## Process Sheet

|                       |                                       |                  |                             |
|-----------------------|---------------------------------------|------------------|-----------------------------|
| Customer              | : CU-DAR001 Dart Helicopters Services | Drawing Name     | : TUBE                      |
| Job Number            | : 26286 <i>ADH</i>                    |                  |                             |
| Estimate Number       | : 12168                               | Part Number      | : D34783                    |
| P.O. Number           | : N/A                                 | Drawing Number   | : D3478 REV A               |
| This Issue            | : 3/16/2006 S.O. No. : N/A            | Project Number   | : N/A                       |
| Prsht Rev.            | : NC                                  | Drawing Revision | : A                         |
| First Issue           | : N/A Type : SMALL /MED FAB           | Material         | : N/A                       |
| Previous Run          | : N/A                                 | Due Date         | : 3/31/2006 Qty: 1 Um: Each |
| Written By            | : <i>SEE COMMENT BELOW</i>            |                  |                             |
| Checked & Approved By | : <i>06.03.16</i>                     |                  |                             |
| Comment               | : Est Rev: A New Issue 06-02-03 JLM   |                  |                             |

## Additional Product

Job Number:



|         |                       |               |
|---------|-----------------------|---------------|
| Seq. #: | Machine Or Operation: | Description : |
|---------|-----------------------|---------------|

|     |           |                     |
|-----|-----------|---------------------|
| 1.0 | M304S26GA | 304/316 0.018 SHEET |
|-----|-----------|---------------------|



Comment: Qty.: 0.1545 sf(s)/Unit Total : 0.1545 sf(s)

Pick:

304/316 0.018 SHEET

(M304S26GA)

Batch: *M19704*
*AB 060328 ①*

|     |       |       |
|-----|-------|-------|
| 2.0 | SHEAR | SHEAR |
|-----|-------|-------|



Comment: SHEAR

Cut Flat pattern 2.00" X 8.79" as per Dwg D3475

*AB 060328 ①*

|     |             |                               |
|-----|-------------|-------------------------------|
| 3.0 | SMALL FAB 1 | SMALL & MEDIUM FAB RESOURCE 1 |
|-----|-------------|-------------------------------|



Comment: SMALL &amp; MEDIUM FAB RESOURCE 1

1-Deburr

2-Roll as per Dwg D3478

3-Form Bead as per Dwg D3478 Using Rotary Machine.

4-Spot Weld as per Dwg D3478 and Dart QSI 018

5-Cut 69 Deg Angle as per Dwg D3478.

*AB 060328 ①*

| W/O: |      | WORK ORDER CHANGES |    |      |     |                                     |                          |
|------|------|--------------------|----|------|-----|-------------------------------------|--------------------------|
| DATE | STEP | PROCEDURE CHANGE   | By | Date | Qty | Approval<br>Chief Eng /<br>Prod Mgr | Approval<br>QC Inspector |
|      |      |                    |    |      |     |                                     |                          |
|      |      |                    |    |      |     |                                     |                          |

Part No: \_\_\_\_\_ PAR #: \_\_\_\_\_ Fault Category: \_\_\_\_\_ NCR: Yes ☐ No ☒ DQA: ☒ Date: 06/03/30

QA: N/C Closed: \_\_\_\_\_ Date: \_\_\_\_\_

| NCR: |      | WORK ORDER NON-CONFORMANCE (NCR) |                                |                                 |                |                           |                       |                          |
|------|------|----------------------------------|--------------------------------|---------------------------------|----------------|---------------------------|-----------------------|--------------------------|
| DATE | STEP | Description of NC<br>Section A   | Corrective Action<br>Section B |                                 |                | Verification<br>Section C | Approval<br>Chief Eng | Approval<br>QC Inspector |
|      |      |                                  | Initial<br>Chief Eng           | Action Description<br>Chief Eng | Sign &<br>Date |                           |                       |                          |
|      |      |                                  |                                |                                 |                |                           |                       |                          |
NOTE: Date & initial all entries

Date: Thursday, 3/16/2006 10:38:38 AM  
User: Kim Johnston

## Process Sheet

Customer: CU-DAR001 Dart Helicopters Services

Drawing Name: TUBE

Job Number: 26286

Part Number: D34783

Job Number:



Seq. #:

Machine Or Operation:

Description :

4.0

QC5

INSPECT WORK TO CURRENT STEP



Comment: INSPECT WORK TO CURRENT STEP

06.03.29

①

5.0

PACKAGING 1

PACKAGING RESOURCE #1



Comment: PACKAGING RESOURCE #1

06.03.29

①

6.0

DC

DOCUMENT CONTROL



Comment: DOCUMENT CONTROL  
Inspection Level 21

06.03.30

①

Job Completion



06.03.29

**Dart Aerospace Ltd**

| W/O: |      | WORK ORDER CHANGES |    |      |     |                                     |                          |
|------|------|--------------------|----|------|-----|-------------------------------------|--------------------------|
| DATE | STEP | PROCEDURE CHANGE   | By | Date | Qty | Approval<br>Chief Eng /<br>Prod Mgr | Approval<br>QC Inspector |
|      |      |                    |    |      |     |                                     |                          |
|      |      |                    |    |      |     |                                     |                          |



Part No: \_\_\_\_\_ PAR #: \_\_\_\_\_ Fault Category: \_\_\_\_\_ NCR: Yes No DQA: \_\_\_\_\_ Date: \_\_\_\_\_


QA: N/C Closed: \_\_\_\_\_ Date: \_\_\_\_\_

| NCR: |      | WORK ORDER NON-CONFORMANCE (NCR) |                             |                                 |                |                           |                       |                          |
|------|------|----------------------------------|-----------------------------|---------------------------------|----------------|---------------------------|-----------------------|--------------------------|
| DATE | STEP | Description of NC<br>Section A   | Corrective Action Section B |                                 |                | Verification<br>Section C | Approval<br>Chief Eng | Approval<br>QC Inspector |
|      |      |                                  | Initial<br>Chief Eng        | Action Description<br>Chief Eng | Sign &<br>Date |                           |                       |                          |
|      |      |                                  |                             |                                 |                |                           |                       |                          |
**NOTE:** Date & initial all entries

PRELIMINARY ISSUE

|  |  |   |                        |
|--|--|---|------------------------|
| DESIGN<br> | DRAWN BY<br> | DART AEROSPACE LTD<br>HAWKESBURY, ONTARIO, CANADA |                        |
| CHECKED  | APPROVED   | DRAWING NO.<br>D3478                              | REV. A<br>SHEET 3 OF 3 |
| DATE<br>05.12.08   |  | TITLE<br>AIR INLET ADAPTER                        | SCALE<br>1:2           |

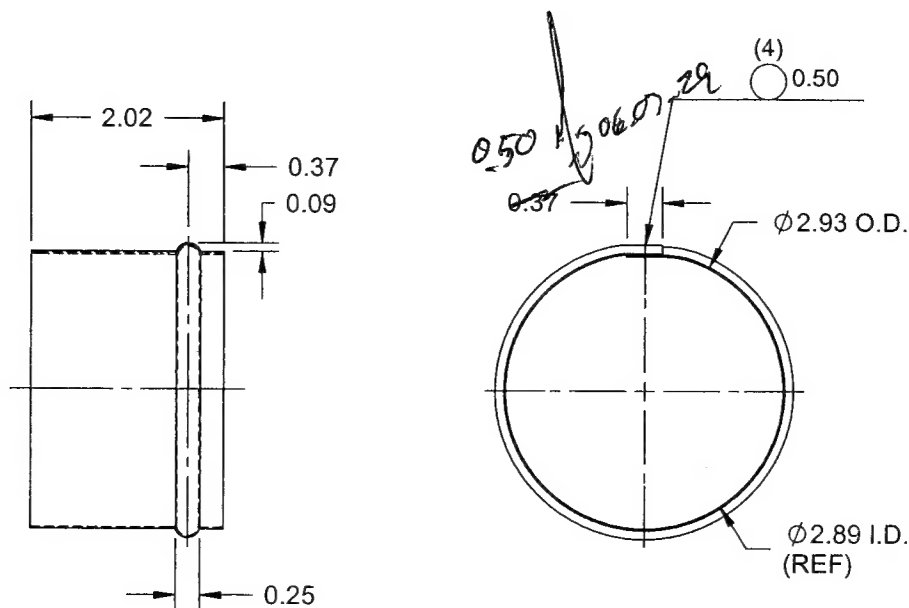

**D3478-3 TUBE**

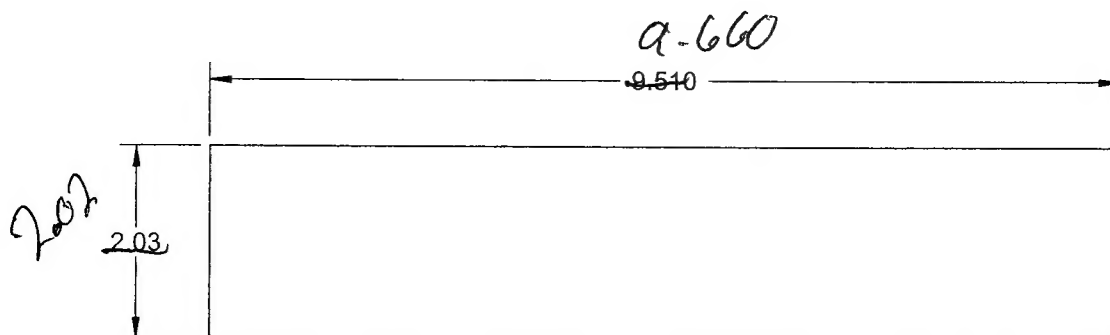

**D3478-3F TUBE FLAT PATTERN**

**NOTES:**

- 1) MATERIAL: AISI 304/316 SS SHEET PER MIL-S-5019 (ANNEALED) 2B FINISH  
26 GAUGE SS (0.018 THICK)  
(REF. DART SPEC. M304S26GA)
- 2) SPOT WELD PER DART QSI 018
- 3) TOLERANCES ARE PER DART QSI 018 UNLESS OTHERWISE NOTED
- 4) ALL DIMENSIONS ARE IN INCHES
- 5) BREAK ALL SHARP EDGES 0.005 TO 0.010

SHOP COPY  
RETURN TO  
ENGINEERING  
UNCONTROLLED COPY  
SUBJECT TO AMENDMENT  
WITHOUT NOTICE  
WORK ORDER  
NO. 26286

COPYRIGHT © 2005 BY DART AEROSPACE LTD.

THIS DOCUMENT IS PRIVATE AND CONFIDENTIAL AND IS SUPPLIED ON THE EXPRESS CONDITION THAT IT IS NOT TO BE USED FOR ANY PURPOSE OR COPIED OR COMMUNICATED TO ANY OTHER PERSON WITHOUT WRITTEN PERMISSION FROM DART AEROSPACE LTD.